



Dart Aerospace Ltd.
1270 Aberdeen St
Hawkesbury, ON
K6A 1K7
Canada

Tel (613) 632-5200

D3290-3
Job Sheet 168934



5032519

Part No: D3290-3

Job Qty: 12 ea

Part Name: Window



Part Weight: 0 lbs

Status: Scheduled

Priority: Medium

Job Created: 11/27/17

Job Tracking No:

Due Date: 12/22/17

Created By: Chantal Lavoie

Type: Stock

Description:

Customer: Hawker Pacific Pty Ltd (CHAWK02)

Locked Bag 2067 Wetherill Park, NSW, 1851 Australia ph:011 61 2 9708 8551

Note: DWG REV C IPP A 04.08.18 New issue KJ/RF IPP B IPP C 07.05.29. Thermoform in-house DL IPP D 07.09.28 rev C dwg EC verified by: DD IPP E 07.11.28 Add --Hand finish deburring DL

Ship Via:

Bill of Materials

Job Routing

Op No	Operation	Qty	Start Date	Due Date	Standard		Workcenter/Supplier		Sign-off
					Setup hrs	Run Hrs	Workcenter / Supplier	Lead Time	
90	Start up Operation	12 Ea	12/22/17	12/22/17	0.00	0.00	Start Up Waterjet		SP18-01-16
100	Purchasing	12 pcs	12/22/17	12/22/17	0.00	0.00	Purchasing		SP18-01-16
105	Packaging	12 pcs	12/22/17	12/22/17	0.00	0.00	Packaging2		
110	QC	12 pcs	12/22/17	12/22/17	0.00	0.00	QC6		EB
190	Packaging	12 pcs	12/22/17	12/22/17	0.00	0.00	Packaging3	3+432	JAN 31 2018
200	QC21-SA	12 Ea	12/22/17	12/22/17	0.00	0.00	QC21		18/01/18

Part Op 100 - ISSUE P/O: _____ SUPPLIER: PLASTECH MANUFACTURE D3290-3 AS PER DWG C OF C
Descriptions: IS REQUIRED

Job Allocations

Operation	Component Part	Required	Inventory	Allocated	Std Qty
100-Purchasing	D3290-3P	12	0	0	0

Part Specifications

Spec No	Description	Target/Tolerance	Limits	Type	Special Comments
1	Window	26.580Inches $\pm$ 0.030	26.610 26.550		
2	Window	16.080Inches $\pm$ 0.030	16.110 16.050		
3	Window	13.790Inches $\pm$ 0.030	13.820 13.760		
4	Window	12.400Inches $\pm$ 0.030	12.430 12.370		
5	Window	8.810Inches $\pm$ 0.030	8.840 8.780		

DART
AEROSPACE
S032619



Window

Dart Aerospace Ltd.

1270 Aberdeen Street
Hawkesbury, ON K64 1K7
CANADA
TEL.: 1 613 632-5200
Email: sales@dartaero.com
www.dartaerospace.com

PART NO: D3290-3

Original Serial #: S032619

Revision:

Operation:

Change No:

Purchasing

Mfg Date: 01/16/18

Job No: 168934

DRAWING NO. D3290	TITLE REPLACEMENT WINDOW ASSEMBLY	REV. C	DART AEROSPACE LTD ENGINEERING ORDER		D.E.O. NO. D3290-C-1	SHEET NO. SHEET 1 OF 1	SCALE NTS
DRAWN <i>90</i>	CHECKED <i>1</i>		MFG. APPR. <i>EZ</i>	APPROVED <i>AD</i>	DE APPR. <i>#</i>		
DATE 09.09.18	DATE 09.09.18		DATE 09.09.18	DATE 09/09/21	DATE 09/09/21		

PURPOSE:

CHANGE MATERIAL THICKNESS OF D3290-1 FRAME TO 0.063 FROM 0.040. REF PAR 09-033.

CHANGE:


MATERIAL CALL-OUT OF D3290-1 FRAME ON SHEET 1 IS AMENDED AS FOLLOWS:


D3290-1 NOTES

- 1) MATERIAL: 6061-T6 (OR 6061-T62) ALUMINUM SHEET ~~0.040 THICK~~ 0.063 THICK (REPLACE)
 PER AMS-QQ-A-250/11 OR AMS 4025 OR AMS 4027
~~(REF. DART SPEC. M6061T6S.040)~~ REF. DART SPEC. M6061T6S.063 (REPLACE)
 OR
 5052-H32 ALUMINUM SHEET ~~0.040 THICK~~ 0.063 THICK (REPLACE)
 PER AMS-QQ-A-250/8 OR AMS 4016
~~(REF. DART SPEC. M5052H32S.040)~~ REF. DART SPEC. M5052H32S.063 (REPLACE)

RELEASED
 2009-10-09
WJ

COPYRIGHT © 2009 BY DART AEROSPACE LTD
 THIS DOCUMENT IS PRIVATE AND CONFIDENTIAL AND IS SUPPLIED ON THE EXPRESS CONDITION THAT IT IS
 NOT TO BE USED FOR ANY PURPOSE OR COPIED OR COMMUNICATED TO ANY OTHER PERSON WITHOUT
 WRITTEN PERMISSION FROM DART AEROSPACE LTD.

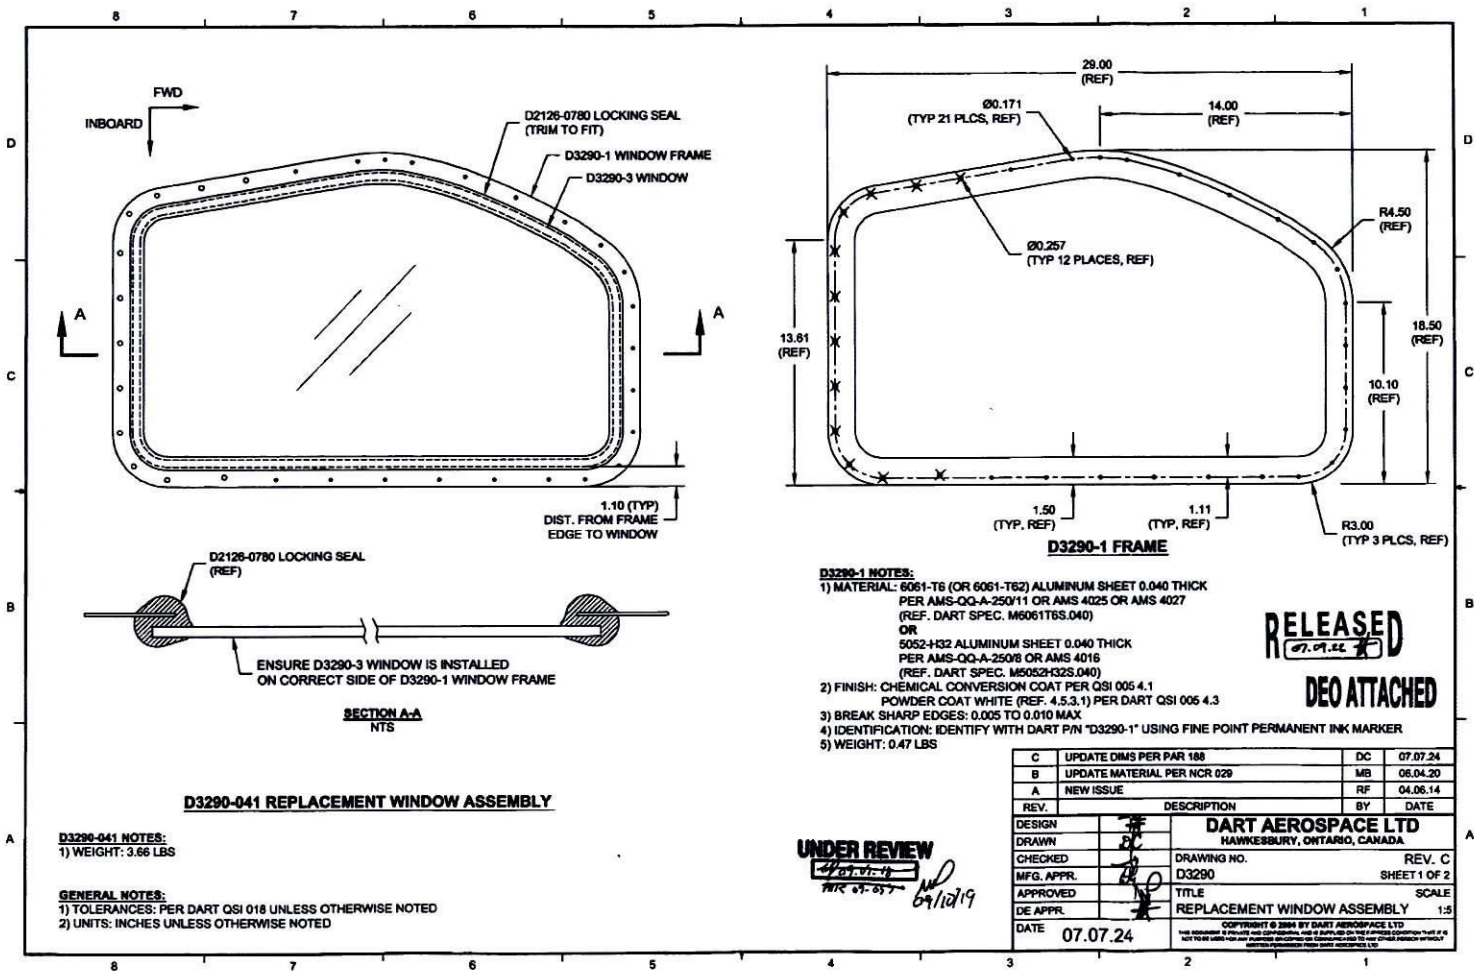

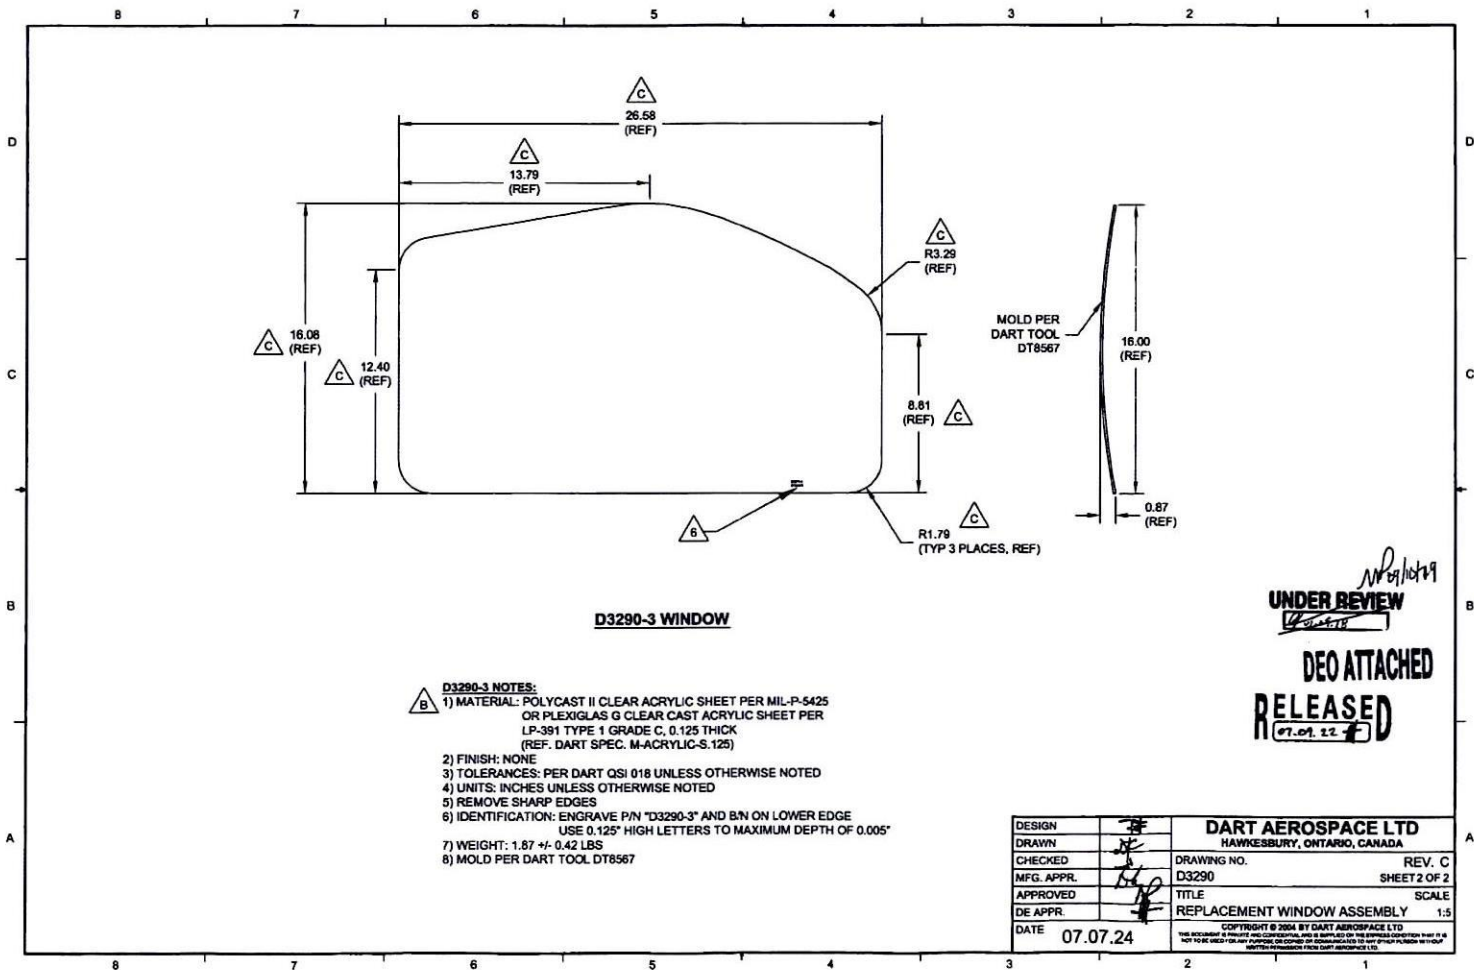



Dart Aerospace Ltd.
1270 Aberdeen St
Hawkesbury, ON
K6A 1K7
Canada

Tel (613) 632-5200

PURCHASE ORDER PO038493

Supplier: PLA002-VC
Plas-Tech
115 Applewood Crescent
Concord
ON
L4K 5C1 Canada
Phone: 416-436-0004
Fax: 416-736-0010

PO No: PO038493
PO Date: 11/27/17
Due Date: 12/19/17
Purchase Order
Revision:
Revision Date:
Ship-To Contact: Phone:

EMailed
NOV 28 2017

Ship To: 1270 Aberdeen Street
Hawkesbury
ON
K6A 1K7 Canada
Phone: 613-632-5200

Via: Ground
Pymt Terms: Net 30
Freight Terms:
Special Comments:

Items

Line Item	Part	Rev	Supplier Part No	Item No	Description	Item Tax	Status	Due Date	Order Quantity	Received Quantity	Balance	Unit Price (CAD)	Extended Price
1	D3290-3P				Window As Per Dwg D3290 Rev. C		Firmed	12/19/17	12 Ea	0 Ea	12 Ea	\$45.00/Ea	\$540.00
Line Item Note job # 168934													
Grand Total: \$540.00													

Order Notes

DWG REV C

Terms & Condition of Purchasing(Suppliers) and Procurement Quality Clauses are an integral part of our AS9100 requirements. To learn in detail, please visit www.dartaerospace.com for further explanation.

Procurement Quality Clauses

- A005 RIGHT OF ENTRY
- A007 FIRST ARTICLE INSPECTION (FAI) BY SELLER, (DOCUMENTATION MAINTAINED BY SUPPLIER)
- A012 CHEMICAL AND PHYSICAL TEST REPORTS
- A016 PERSONNEL QUALIFICATION
- A017 RAW MATERIAL IDENTIFICATION (AS APPLICABLE)
- A026 CERTIFICATION OF MATERIAL CONFORMANCE
- A041 QUALITY MANAGEMENT SYSTEM
- A042 DART NOTIFICATION BY SUPPLIER
- A043 RETENTION OF QUALITY DOCUMENT
- A048 COUNTERFEIT PARTS AVOIDANCE, DETECTION, MITIGATION AND DISPOSITION PROGRAM
- A049 SUPPLIER AWARENESS

Plex 11/27/17 3:41 PM dart.baker.diane

Packing Slip



115 Applewood Crescent
Concord, ON, L4K 5C1
PLASTECHONLINE.COM
P- 416 736 0004
F- 416 736 0010

Shipment Number: 26395
Shipment Date: 01/10/2018
BOL Number:
Customer Key: C1887
Salesperson: MIKE AUBE
Page Number: 1 of 1

B DART AEROSPACE LTD.
I 1270 ABERDEEN STREET
L HAWKESBURY ON K6A 1K7
L CA
T Attn: DALE BATES
O

S DART AEROSPACE
H 1270 ABERDEEN STREET
I HAWKESBURY ON K6A 1K7
P CA
T Attn: ROBERT ABOUD
O

Purchase Order
38493
Carrier Account #

Sales Order
SO-021328

Incoterms
EX WORKS

Payment Method
PPD/CHG
Tracking Number

Ship Via
UPS CANADA LTD. -

Item Number - Revision Description

D3290-3 - Rev.: C REPLACEMENT WINDOW ASSEMBLY

HS Code: 3920.51.1000 - OTHER Country of Origin : CA

FREIGHT - FREIGHT

Quantity UOM
Shipped

12 EA

1 EA

8218-01-14

Number of Containers

Gross Weight

Shipped By

Certificate Of Conformance



Customer: DART AEROSPACE LTD

P.O. # 38493

SO # 021328

Part #	D3290-3	Qty.	12	Batch #	-001
Description	WINDOW, FOR REPLACEMENT WINDOW ASSEMBLY	Material usage	2 SHEETS	Lot#	240394
Part #		Qty.		Batch #	
Description		Material usage		Lot#	
Part #		Qty.		Batch #	
Description		Material usage		Lot#	
Note: All parts are not identified as meeting QSI044.

By: AS

(Approved QA Signatory)

Date: JAN 08, 2018

C OF C # 028

Page: 1 of 1

COPY

Plas-Tech Inc. 115 Applewood Cres. Concord, Ontario L4K 5C1 Tel: (416) 736-0004 Fax: (416) 736-0010

Email: info@plastechonline.com, Web: www.plastechonline.com